


CLIENT:

PRINCIPAL REAL ESTATE HOLDINGS, INC.
RIVERSIDE COUNTY TRAVEL ZONE LLC
COO & CO-FOUNDER

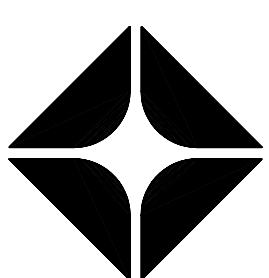


BRAND: ARCO
BY WEST COAST PRODUCTS, LLC

CONSULTANT:

WESTERNSTATES
Engineering & Construction, Inc.
733 N. MAIN ST.
ORANGE, CA 92666
714/ 769-2000
714/ 769-2002 Fax
www.weststatesinc.com
A "Design/Build" Co.

NO.	DATE	REVISION DESCRIPTION
1	11-17-03	BUILDING SUBMITTAL
2	11-17-03	REVISION PER PLAN CHECKS
3	11-17-03	REVISION PER PLAN CHECKS
SEAL:

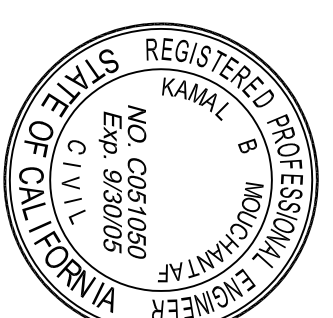


CONFIDENTIALITY STATEMENT:
THE SIGNATURE OF THIS ARCHITECTURAL FIRM AND THE SEAL OF THE REGISTERED PROFESSIONAL ENGINEER ARE NOT TO BE REPRODUCED OR TRANSMITTED IN ANY FORM OR BY ANY MEANS, ELECTRONIC OR MECHANICAL, INCLUDING PHOTOCOPYING, RECORDING, OR BY ANY INFORMATION STORAGE AND RETRIEVAL SYSTEM, WITHOUT THE WRITTEN PERMISSION OF WESTERNSTATES ENGINEERING & CONSTRUCTION, INC. ANY REPRODUCTION OR TRANSMISSION OF THIS DOCUMENT WITHOUT THE WRITTEN PERMISSION OF WESTERNSTATES ENGINEERING & CONSTRUCTION, INC. IS STRICTLY PROHIBITED. THE ARCHITECTURAL FIRM AND THE REGISTERED PROFESSIONAL ENGINEER SHALL BE HELD RESPONSIBLE FOR THE ACCURACY AND COMPLETENESS OF THE INFORMATION PROVIDED HEREIN. THE ARCHITECTURAL FIRM AND THE REGISTERED PROFESSIONAL ENGINEER SHALL NOT BE HELD RESPONSIBLE FOR THE ACCURACY AND COMPLETENESS OF THE INFORMATION PROVIDED BY OTHERS.

DEVELOPMENT INFORMATION:
NEW BUILD (STICK)
3600 SERIES AM/PM
CENTER CASHIER
TO GO DELI

SITE ADDRESS:
23261 CALALCO EXWY.
@ BAYVIEW AVENUE
FERRIS, CALIFORNIA 92521

DESIGNED BY: HILANCE ZHANG
CHECKED BY: JIP REPPE
DRAWN BY: HILANCE ZHANG
VERSION: V01
PROJECT NO: 11.17.03
DRAWING TITLE: BUILDING # 1
REFLECTED
CEILING PLAN

SHEET NO: DOFO
A.1.3b

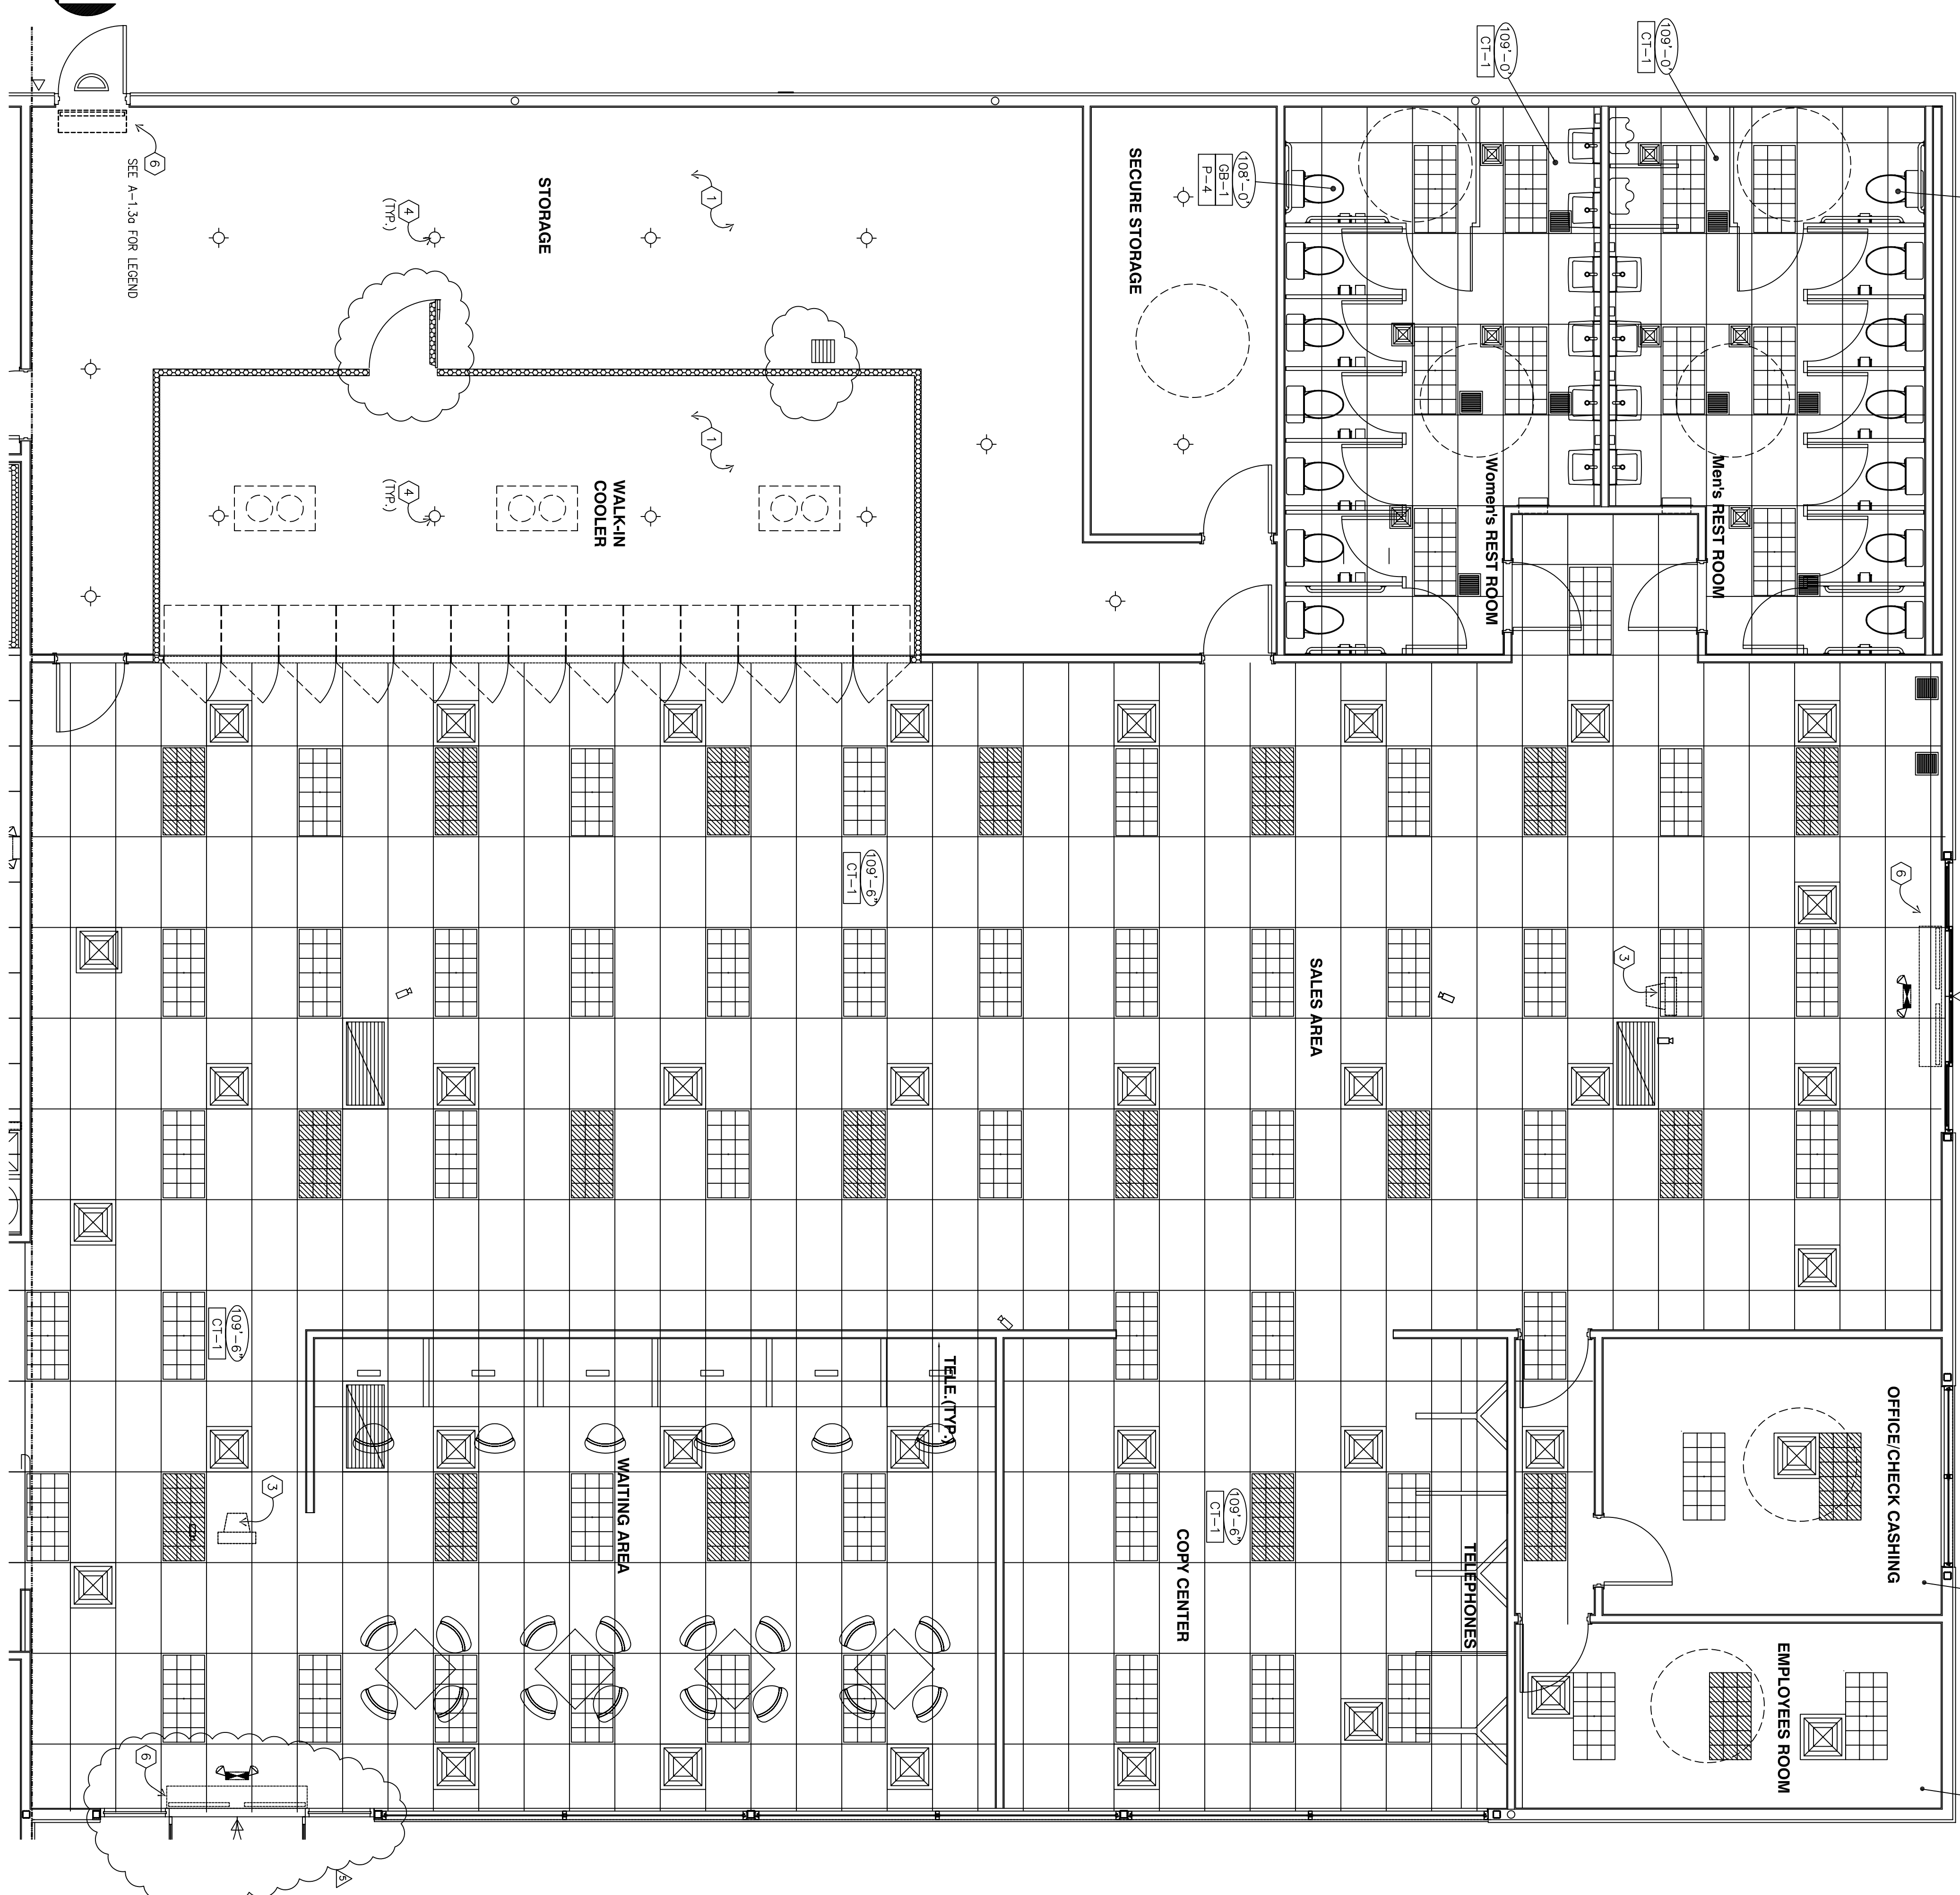

REFLECTED CEILING PLAN

SCALE: 1/4" = 1'-0"

SCALE: 1/4" = 1'-0"

